

ID 2001/3538



2011

773

1798

1747

~~1695~~

807

813

3271

853

762

858

857

856

1932

1933

Echelle 1 : 1000

En Lotissement

3260

3261

3263

748

3259

762

3229

~~778~~

12507

1931

1936

1673

1934/5

1933/3/40

1937

~~1934~~

1931

1934/5

1933/3/40

1937

~~1934~~

1931

1934/5

1933/3/40


1937

~~1934~~

1931

1934/5



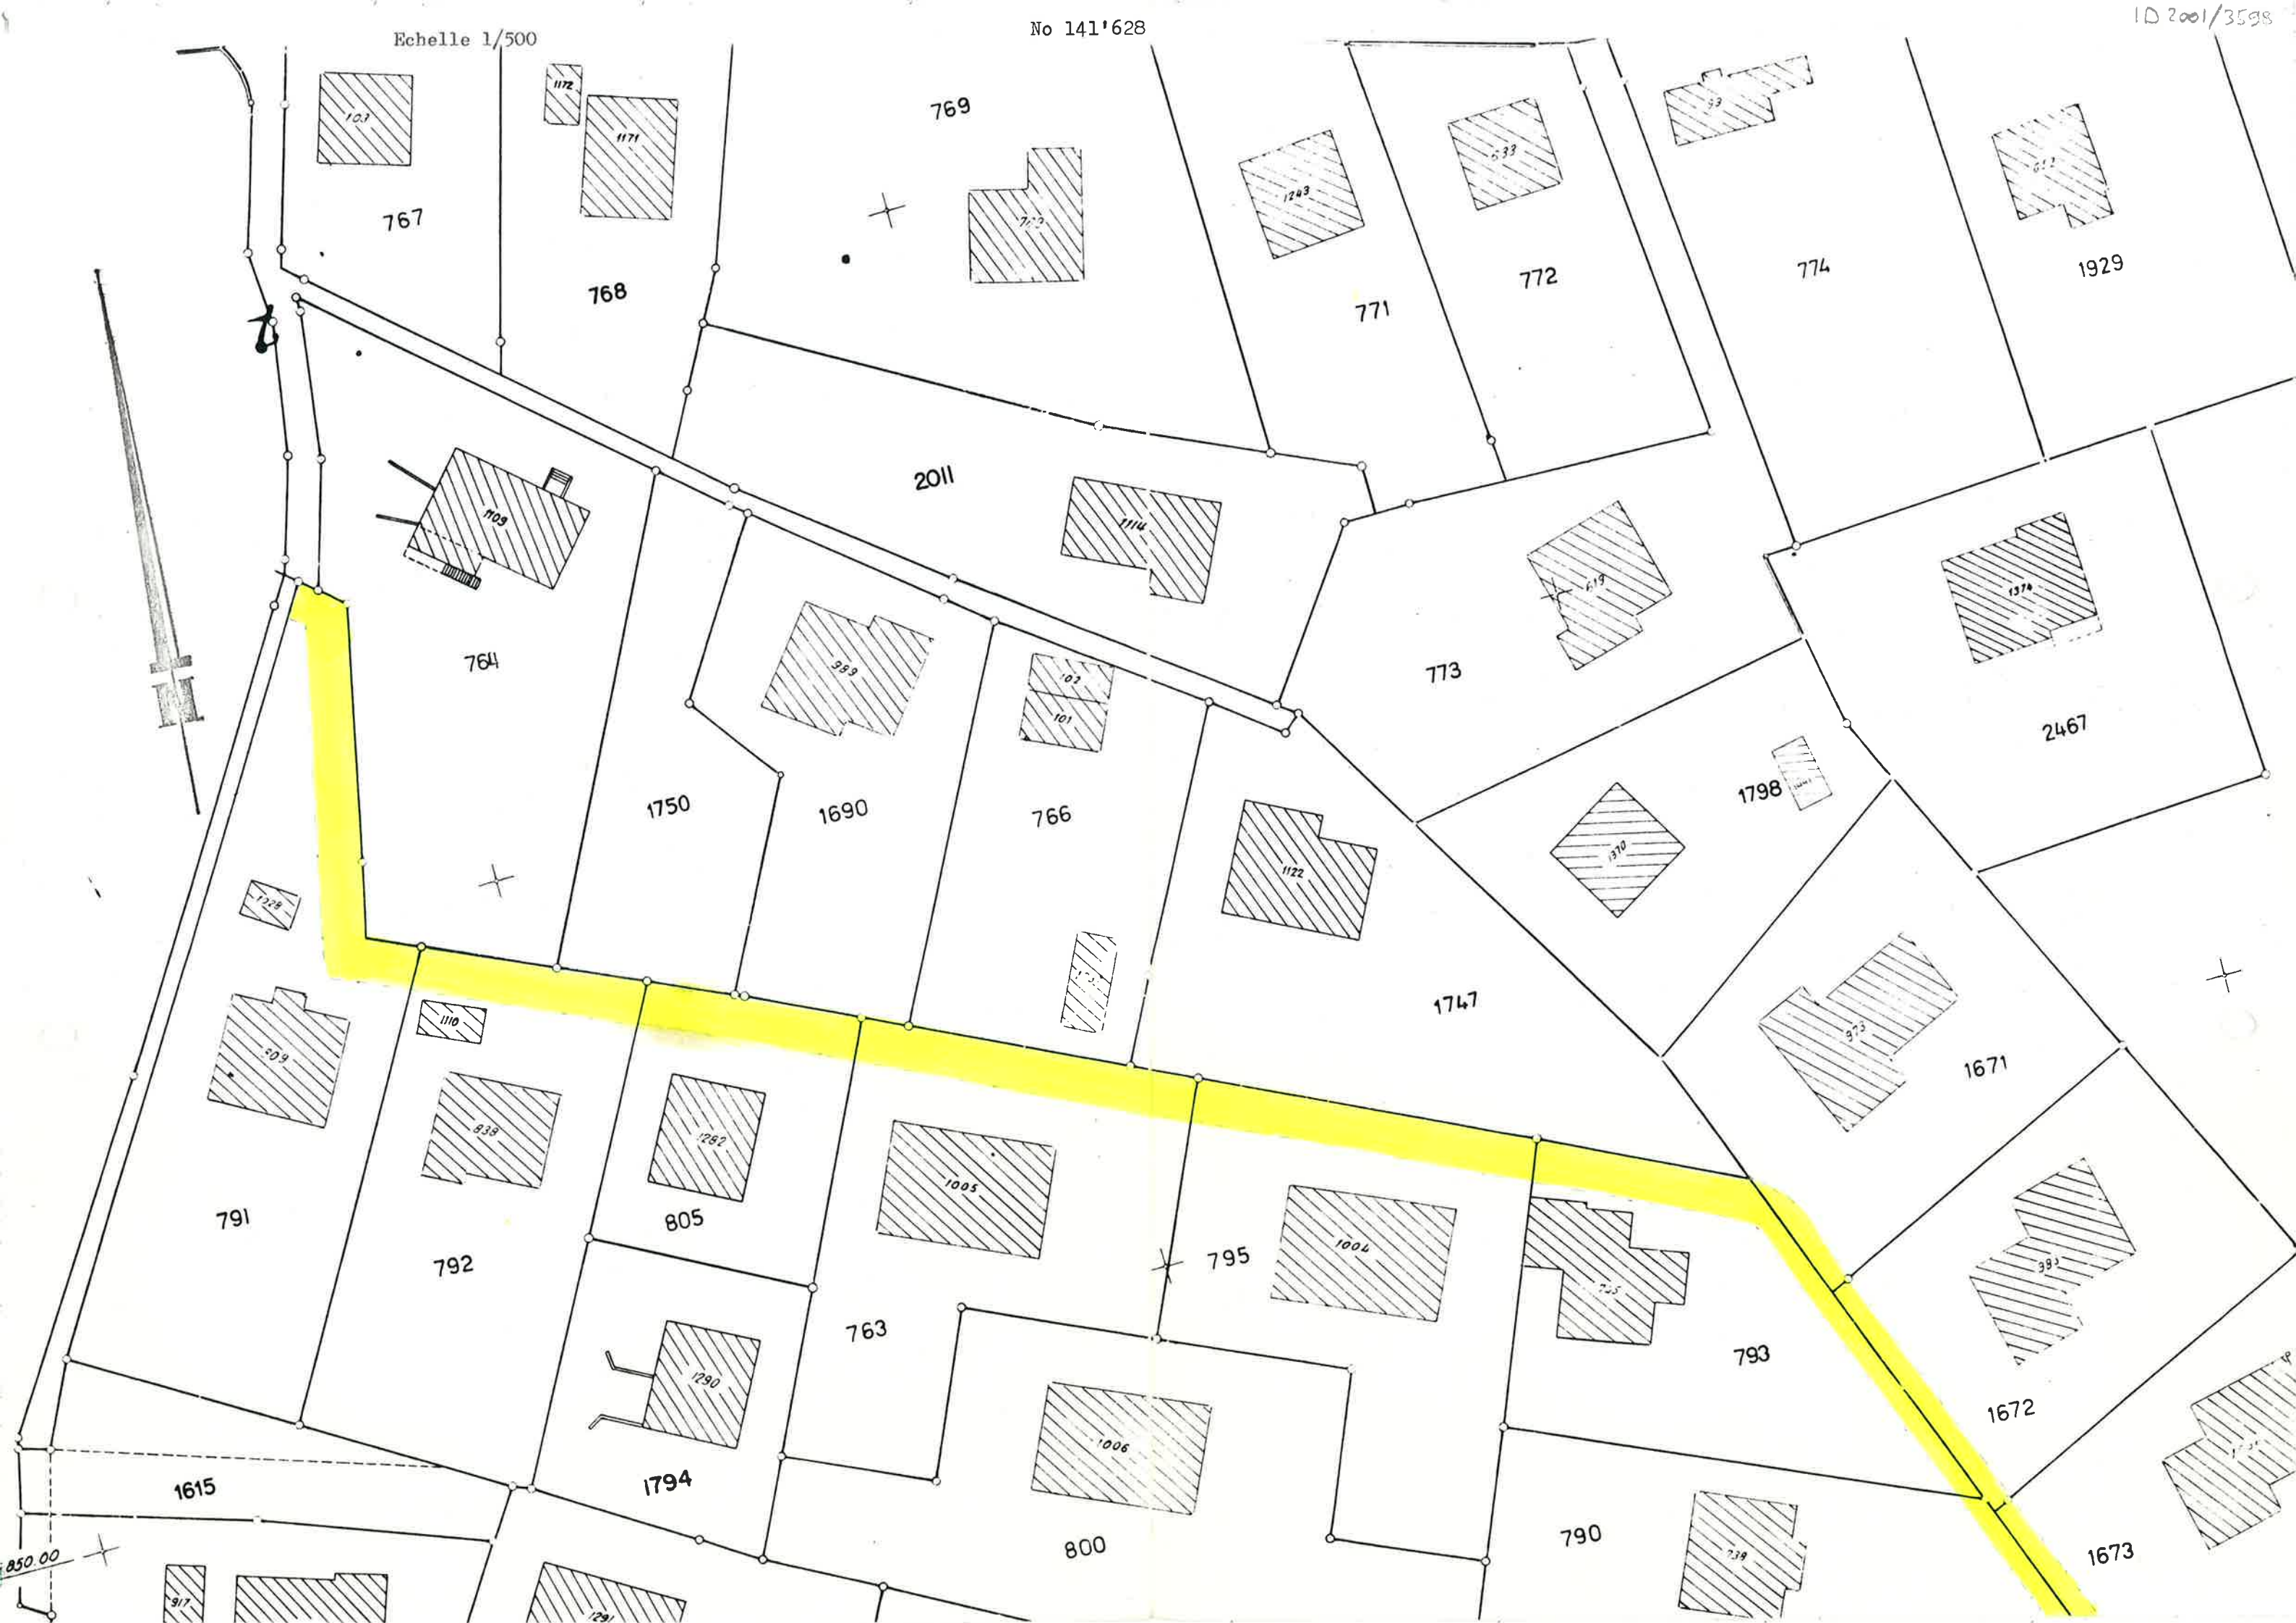



Echelle 1/500

No 141'628

No 141'628

ID 2001/3598

790

1673

1940

1939

1938

1937

1936

1799

1932

1933

2349

Lausanne

n

3271

L

a

v

a

n

c

h

y






813

813

762

859

762

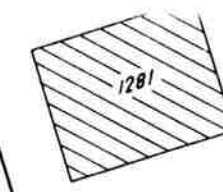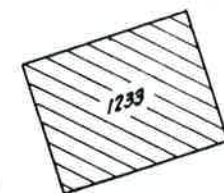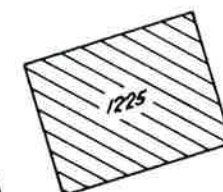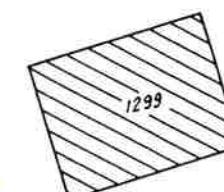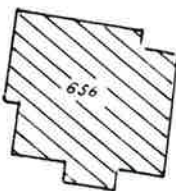

748

3259

858

748

857

856

752

753

